


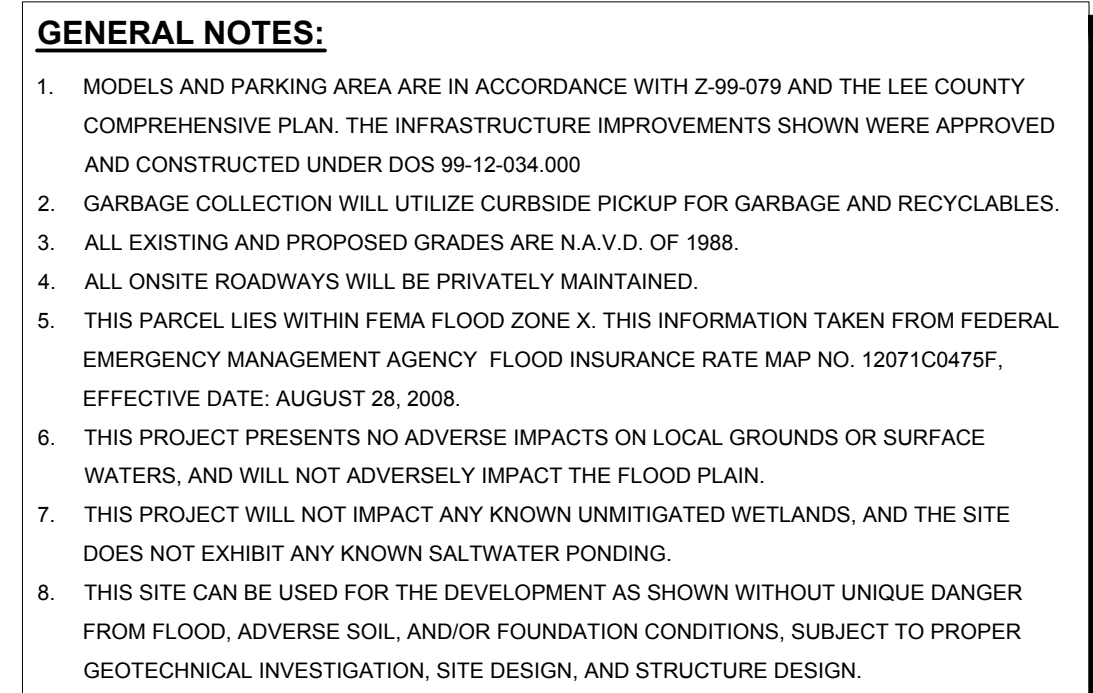

OFFICE AND DISPLAY AREA: (OFFICE 1 SPACE / 300 SF FLOOR AREA)
 PARKING REQUIRED = 1000 SF / 300 SF = 3.3 SPACES ≈ 4 SPACES
 PARKING PROVIDED = 7 PARKING SPACES (INCLUDING 1 H/C SPACE)

LEGEND:

C	INDICATES CENTERLINE
LB	INDICATES LICENSED BUSINESS
P.T.	INDICATES POINT OF TANGENCY
D.E.	INDICATES DRAINAGE EASEMENT
P.C.	INDICATES POINT OF CURVATURE
EB	INDICATES ENGINEERING BUSINESS
P.U.E.	INDICATES PUBLIC UTILITY EASEMENT
R.L.S.	INDICATES REGISTERED LAND SURVEYOR
L.M.E.	INDICATES LAKE MAINTENANCE EASEMENT
C1	INDICATES CURVE DATA. SEE CURVE TABLE

PREPARED FOR:

AQUABELLA DEVELOPMENT, LLC

10481 SIX MILE CYPRESS PARKWAY
FORT MYERS, FL. 33966
PHONE: (239) 278-1199
FAX: (239) 278-3174

BANKS
ENGINEERING
Professional Engineers, Planners, & Land Surveyors
Serving The State Of Florida

DAVID R. UNDERHILL JR.
P.E. #47029

DATE	PROJECT	DRAWING	DESIGN	DRAWN	CHECKED	SCALE	SHEET
MAY 2023	3142L	MSP	JLW	JLW	DRU	1"=20'	04