



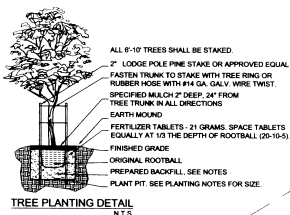

D.O. PLANS FOR

CASE #: LDO 2000-00075

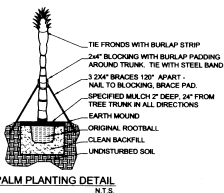

EXISTING CARRAGE PALMS

ISLAND PARK ROAD

PHARMACY

PUBLIX
SUPERMARKET

47 EXISTING MAHOGANIES ALONG PROPERTY LINE WITH 8' WALL

TYPE 'A' BUFFER
1055 LF. = 42 Trees and 0 Shrubs (8' Wall) Required
~~47 Trees and 0 Shrubs Required~~

PROPOSED LANDSCAPE RENOVATION

PLANT MATERIALS LIST

KEY	QTY	BOTANICAL NAME	COMMON NAME	SPECS
		TREES/PALMS		
IC	12	Ilex cassine	Dahoon Holly	10' OAH
CSG	13	Cordia sebestena	Geiger Tree	10' OAH
SP	30	Sabal palmetto	Cabbage Palm	15'-20' CT, Staggered hts.
		SHRUBS		
GG	22	Galphimia gracilis	Thyralis	3 gal., 18"-24" OA 36" OC
MC	96	Myrica cerifera ALT: Viburnum obovatum	Wax Myrtle Walters Viburnum	3 gal., 24"-36" OA 48" OC 3 gal., 24"-36" OA 48" OC
TD	91	Tripsacum dactyloides	Fakahatchee Grass	3 gal., 24"-36" OA 48" OC
		VINES/GROUNDCOVERS		
LME	143	Liriope muscari 'Evergreen Giant'	'Evergreen Giant' Liriope	1 gal., Full 24" OC

TOTAL AREA = 11.55 ACRES
 11.5 X 43,560/5,000 = 100 TREES REQUIRED (EXCLUDING BUFFER AREAS)
~~TOTAL REQUIRED = 102 (INCLUDING 10% SHADING)~~
 INTERIOR LANDSCAPING REQUIRED = 8,614 SQ. FT.
 INTERIOR LANDSCAPING PROVIDED = 9,000 SQ. FT.


— EXISTING MAHOGANY TO REMAIN

LEE COUNTY DEVELOPMENT SERVICES APPROVAL


By: WHL Date: 03/09/00

FOR: Revised landscape plans
LDO 2000-00075

* APPROVAL BASED ON SITE INFORMATION SUPPLIED BY APPLICANT

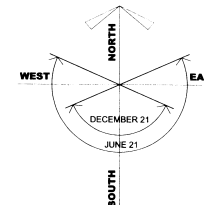

PROJECT NO. 99-117 SCALE 1"=50' DRAWN JF69 CHECKED TA DESIGNED TA		LANDSCAPE RENOVATION PLAN REGISTERED LANDSCAPE ARCHITECT FORT MYERS THERESA ARVISO, ASLA		LANDSCAPE RENOVATION PLAN REGISTERED LANDSCAPE ARCHITECT FORT MYERS THERESA ARVISO, ASLA	
US 41 AND ISLAND PARK RD. ISLAND PARK SHOPPING CENTER		US 41 AND ISLAND PARK RD. ISLAND PARK SHOPPING CENTER		US 41 AND ISLAND PARK RD. ISLAND PARK SHOPPING CENTER	
2 of 2 2 3 4 5		2 of 2 2 3 4 5		2 of 2 2 3 4 5	
2210 2210 2210 2210 2210		2210 2210 2210 2210 2210		2210 2210 2210 2210 2210	
2210 2210 2210 2210 2210		2210 2210 2210 2210 2210		2210 2210 2210 2210 2210	
2210 2210 2210 2210 2210		2210 2210 2210 2210 2210		2210 22	

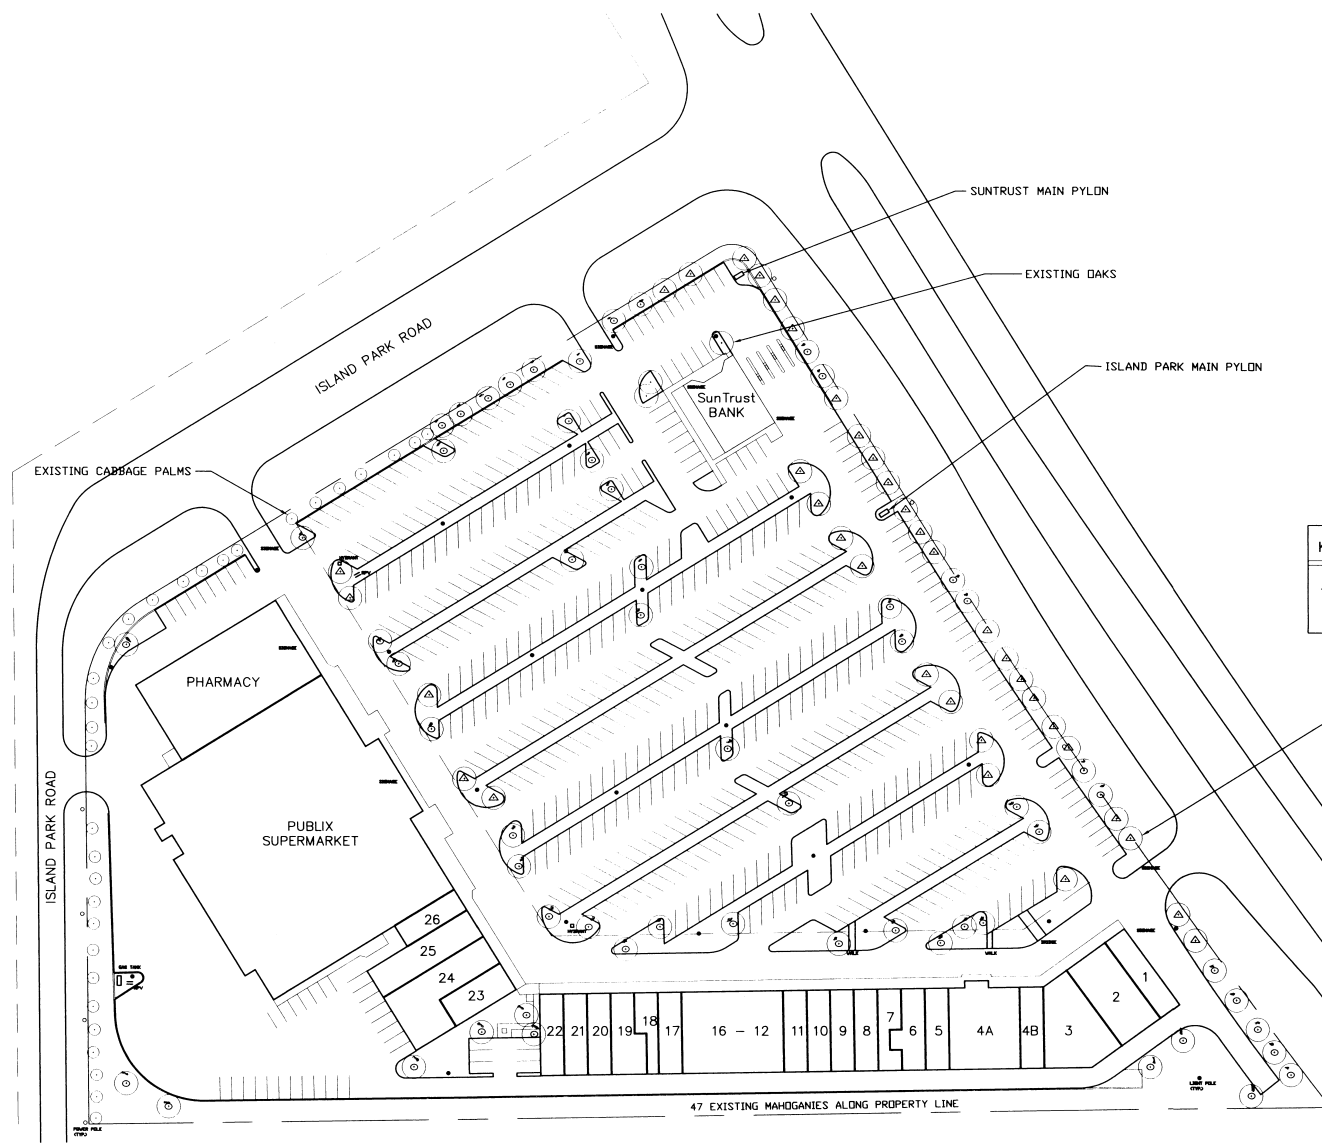


KEY	MAHOGANY TREES
△	TO BE REMOVED 37
○	TO REMAIN 58 + 47

31 SP
3 AV
176 Total Existing Trees

EXISTING MAHOGANY TREES

LEE COUNTY DEVELOPMENT SERVICES APPROVAL
 BY: *[Signature]* DATE: 02/03/10
 FOR: *[Signature]*
 LDC-2000-00075
 * APPROVAL BASED ON SITE INFORMATION SUPPLIED BY APPLICANT

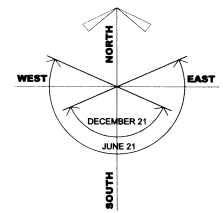

EXISTING TREE LOCATIONS

BURNER & Company Site Planning, Landscape Architecture Studio: (941) 692-5090 Fort Myers, FL 33905 FAX: (941) 692-5190 LCC000228		FLORIDA FORT MYERS LANDSCAPE RENOVATION PLAN ISLAND PARK SHOPPING CENTER US 41 AND ISLAND PARK RD. Theresa Artuso, AIA Registered Professional Architect License No. 12574 DATE: 12-29-10
PROJECT NO. 99-117	SHEET NO. 1 OF 2	CHECKED: TA DATE: 2.21.00 DRAWN: JFSS DATE: 2.21.00 CHECKED: TA DATE: 2.21.00 SCALE: 1"=50'